WTCI Documents Database - Data Entry Report

Initial Document Information

File Category ID: 4333 / WTCI - 000043 - SOM
Delivery Method: Mail
Document Type: Drawing
Format Type: Hard Copy

Date Entered: 6/20/2006
Date Received: 11/15/1989
Document Date: 11/15/1989
Number Copies: 1

Detailed Document Information

Sender ID No.: SOM Box 4102
Primary Organization: SOM
Forwarded by: Tully, Bernard
Forwarded by (Org. Name): Morse Diesel
Document ID Number: SOM Box 4102
Document Author: Tully, Bernard
Document Author 2: NA, NA
Document Author 3: NA, NA
Doc. Author (Org. Name): Morse Diesel
Document Addressee: Ryan, John
Doc. Address. (Org. Name): Centrifugal Associates, Inc.
Document Title: Salomon Brothers Fuel Oil Piping
Attachments: No
Attachment Title(s):

Technical Categorization

Classification: Materials Agreement
Keywords: WTC 7
Mech/Elec
Fuel Distribution System
Category Name: Skidmore, Owings, & Merrill LLP
Category Abbrev.: SOM
Room Location: SOM
Cabinet Location: 102
Notes:

Copy 5 pgs total

SALOMON BROS

Job #6234 (7 W.T.

INDEX 133 TO 135

101

4102

Morse Diesel
Construction/Consulting

1515 Broadway
New York, NY 10036
212 730-4000

WTCI-43-SOM

November 15, 1989

Mr. John Ryan
Centrifugal Associates, Inc.
150 East 42nd Street
New York, NY 10017

RE: SBI - World Trade Center

Dear Mr. Ryan:

You are directed to proceed with the installation of your fuel oil piping as shown on attached Flack and Kurtz sketch SK-F02-1 Dated 11-9-89. If there are scope changes or work N.I.C. advise the writter.

Prepare a drawing detailing dimensions, pipe sizes elevations, cathodic protection etc. for approval.

This sketch supersedes the MI.1 "B" action from Flack and Kurtz.

Very truly yours,

MORSE/DIESEL, INC. AS Agent
for Salomon Brothers, Inc.

Bernard Tully
Mech. Project Manager

BT/ccr

Enclosure

cc: R. Pavesi
J. Driscoll
J. Glass
S. Barkin
B. Hauser
B. Reinholtz
J. Mesagno
D. Cooper
R. Miller
B. Tully

CENTRIFUGAL ASSOCIATES INC.

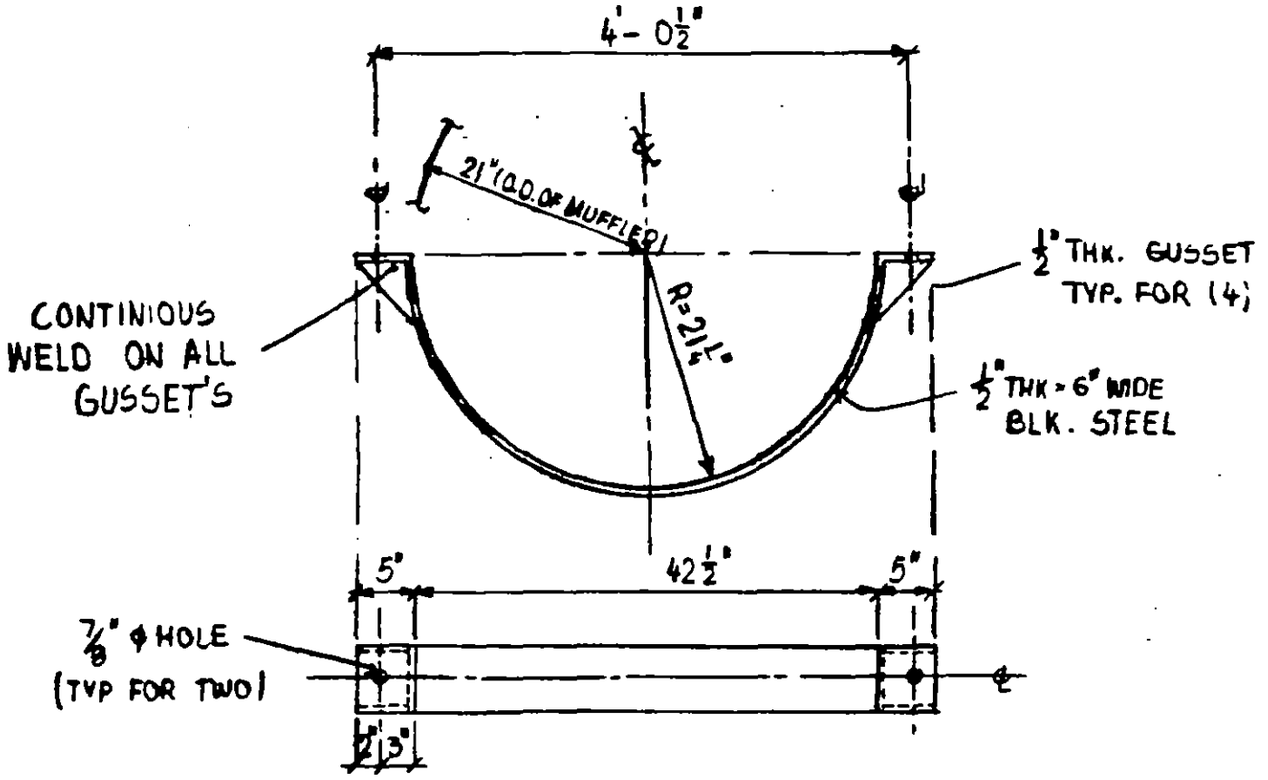

SUBMITTED FOR APPROVAL
CENTRIFUGAL ASSOCIATES, INC.
MECHANICAL CONTRACTING DIVISION
150 EAST 42nd STREET
NEW YORK, NEW YORK 10017
DATE 11/8/1989

MUFFLER HANGERS

7 WORLD TRADE CENTE
SALOMON BROTHERS

Scale ¾" = 1'-0"

11-8-89

Revd 11-14-89 h/D

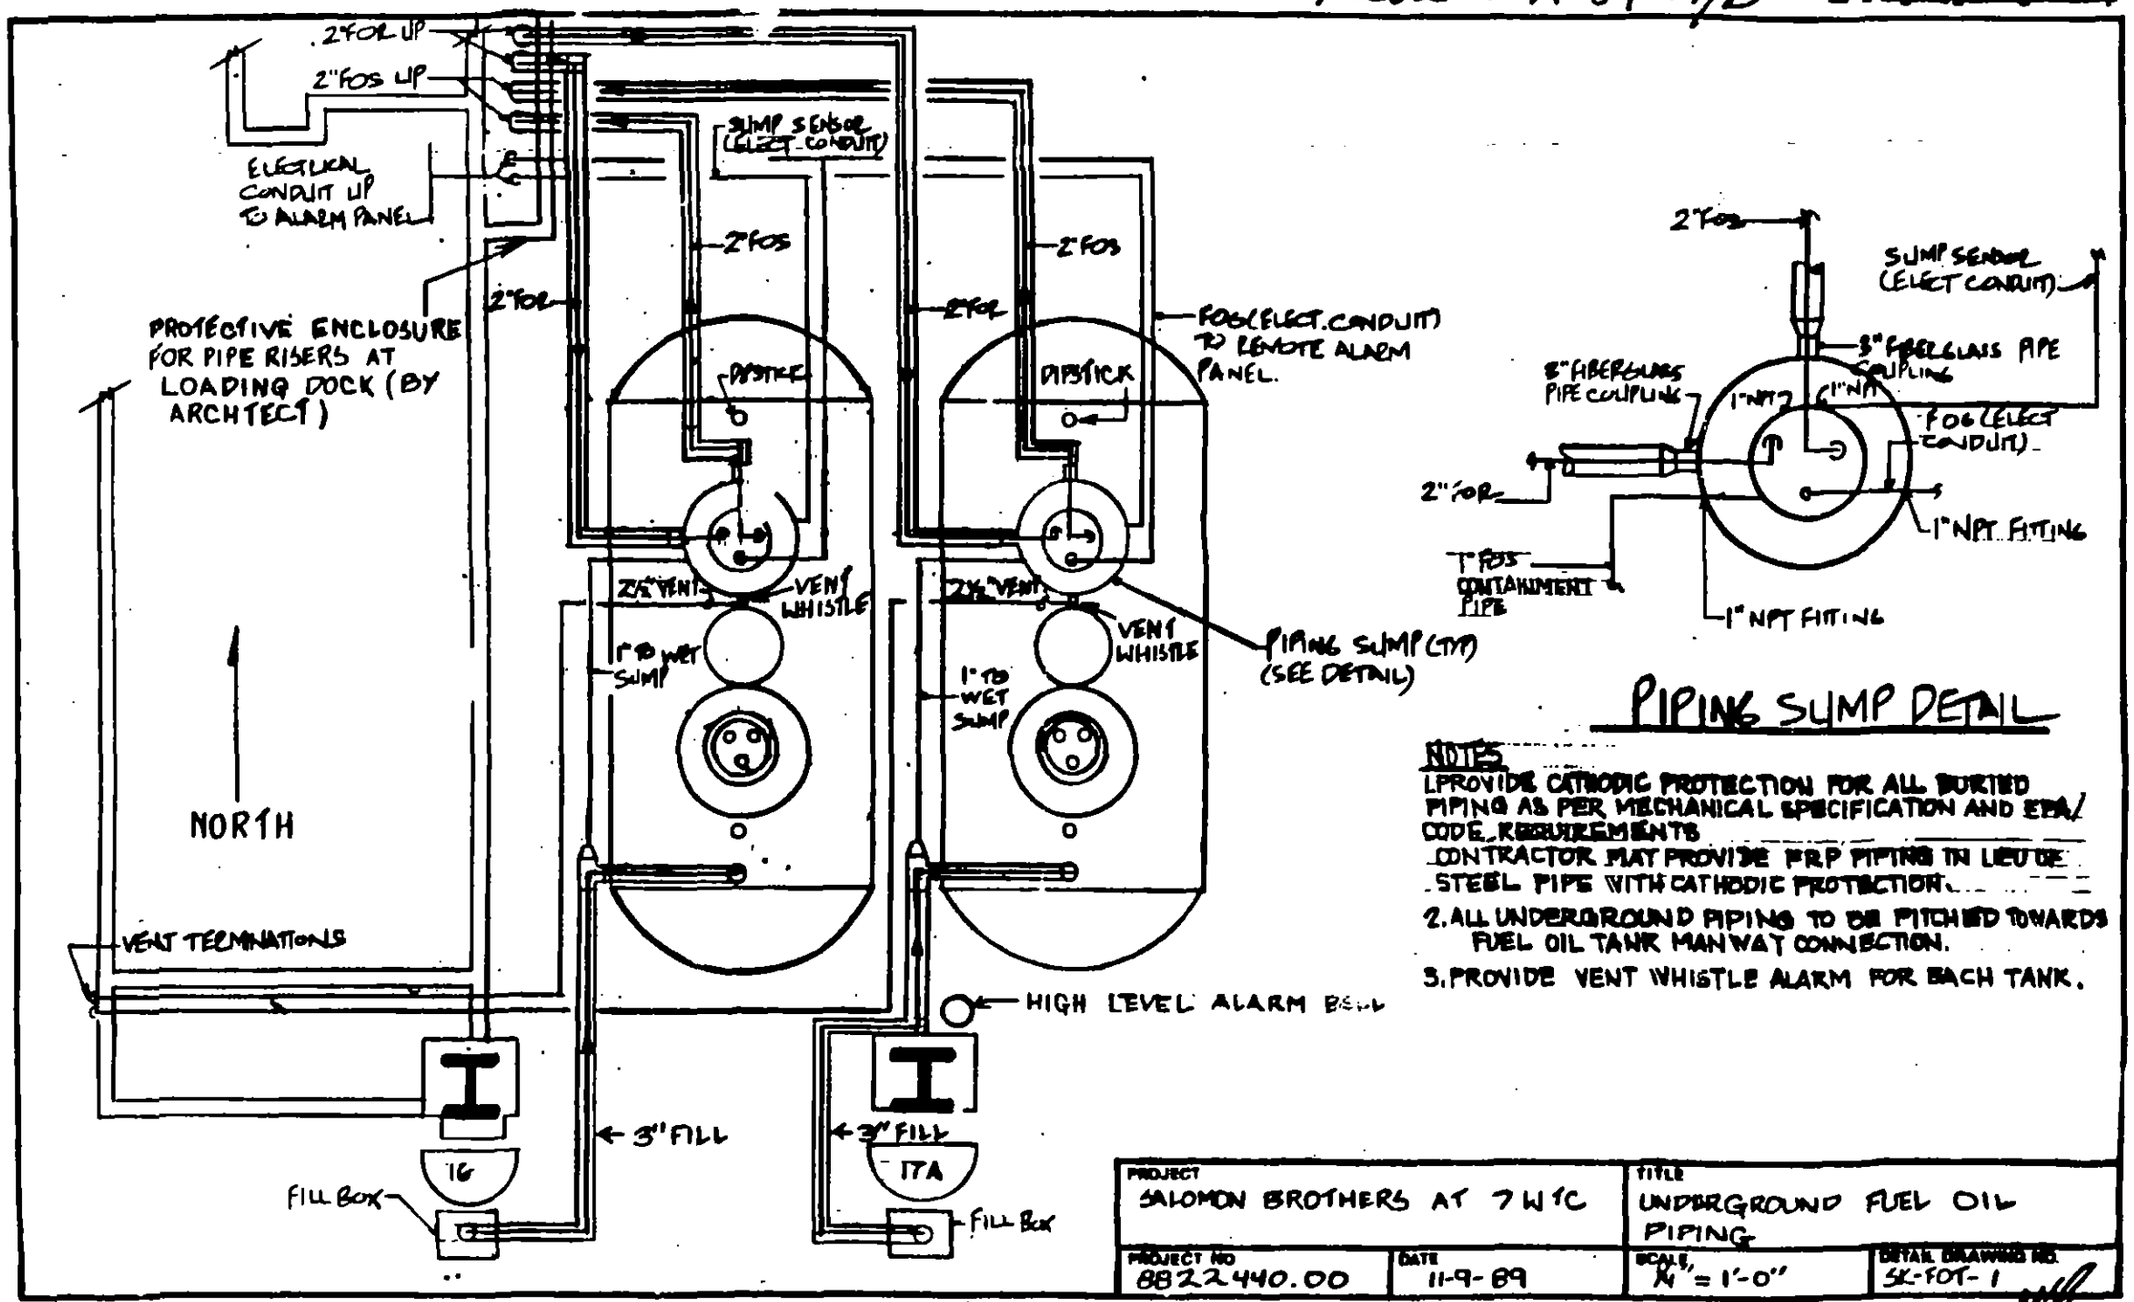

PIPING SUMP DETAIL

NOTES

1. PROVIDE CATHODIC PROTECTION FOR ALL BURIED PIPING AS PER MECHANICAL SPECIFICATION AND EPA/ CODE REQUIREMENTS
   CONTRACTOR MAY PROVIDE FRP PIPING IN LIEU OF STEEL PIPE WITH CATHODIC PROTECTION.
2. ALL UNDERGROUND PIPING TO BE PITCHED TOWARDS FUEL OIL TANK MANWAY CONNECTION.
3. PROVIDE VENT WHISTLE ALARM FOR EACH TANK.

PROJECT: SALOMON BROTHERS AT 7 WTC		TITLE: UNDERGROUND FUEL OIL PIPING	
PROJECT NO: 8822440.00	DATE: 11-9-89	SCALE: 1/4" = 1'-0"	DETAIL DRAWING NO: SK-FOT-1

ME 11/9/89

MORSE/DIESEL, INC.

CLARIFICATION/CONFLICT

C/C NO. JS-005 RE: AIRCRAFT WARNING LIGHTS & JOHNSON CONTROL SENSORS

FROM: JIM SHOOP / MD TO: BOB LEVINE

DATE: 15 NOVEMBER 1989

PLEASE FURNISH THIS OFFICE WITH A RESOLUTION TO THE FOLLOWING ITEMS:

1. FINAL LOCATION OF THE AIRCRAFT WARNING LIGHTS, RE-ROUTING OF EXISTING FEEDER TO SAME.
2. RE-ROUTING OF CONDUITS FOR JOHNSON CONTROL SENSORS, RE-LOCATION OF JOHNSON CONTROL SENSOR ON EAST WALL.

WE REQUIRE THIS INFORMATION BY 20 NOV 89, AS THESE ITEMS ARE AFFECTING THE INSTALLATION OF THE CLADDING, AND BAD WEATHER IS COMING FAST.

APPROVED BY: _____

FIRM NAME: _____

DATE: _____

cc: S. ORR
R. PAVESI
B. REINHOLTZ
J. DRISCOLL
B. TULLY
D. MARSH
FILE

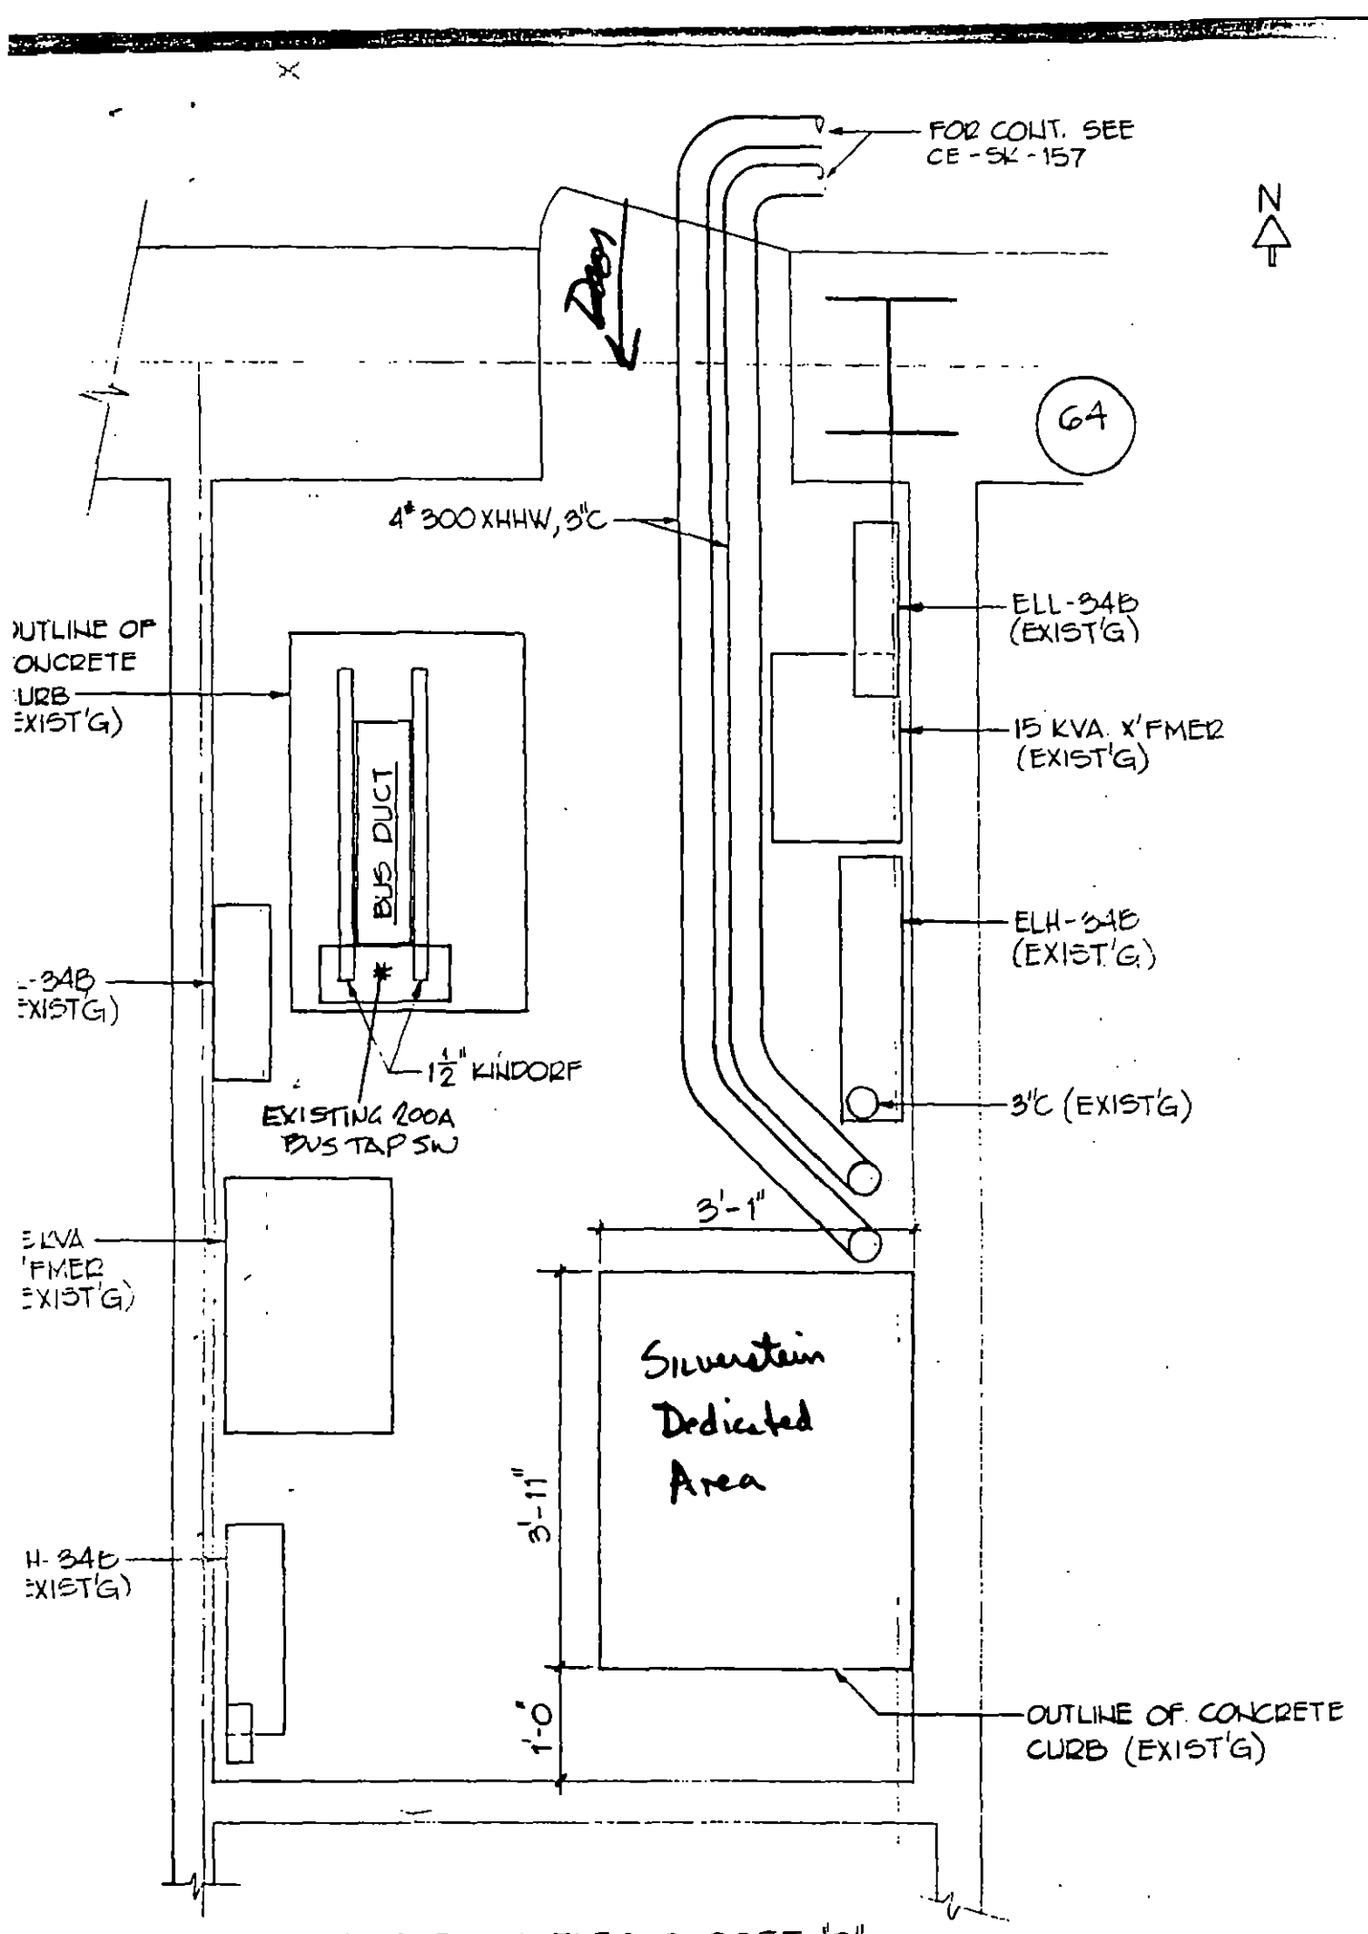

PART PLAN - ELEC. CLOSET "B"
34TH FLOOR

SALOMON BROTHERS, INC.
7 WORLD TRADE CENTER
COYNE ELECTRICAL CONTRACTORS, INC.
DWG.# CE-SK-151
DATE: 9-27-89

AS BUILT